

Date: Tuesday, 10/06/2008 12:53:56 PM  
 User: Julie Lecocq

## Process Sheet

|  |  |
|--|--|
| <b>Customer</b> : CU-DAR001 Dart Helicopters Services  | <b>Drawing Name</b> : 206L UTILITY BASKET                  |
| <b>Job Number</b> : 39779  |  |
| <b>Estimate Number</b> : 11272   |  |
| <b>P.O. Number</b> :   | <b>Part Number</b> : D206540011                            |
| <b>This Issue</b> : 10/06/2008 <b>S.O. No.</b> :   | <b>Drawing Number</b> : D206-540 REV I                     |
| <b>Prsht Rev.</b> : NC   | <b>Project Number</b> : N/A                                |
| <b>First Issue</b> : / / <b>Type</b> : LARGE FAB ASSY  | <b>Drawing Revision</b> : I                                |
| <b>Previous Run</b> : 36655  | <b>Material</b> :  |
| <b>Written By</b> :  | <b>Due Date</b> : 30/06/2008 <b>Qty:</b> 1 <b>Um:</b> Each |
| <b>Checked &amp; Approved By</b> : <u>JLD 08.10.10</u>   |  |
| <b>Comment</b> : Est Rev:I Revised per Rev I 05-12-06 JLM<br>Est Rev:H 07-03-20 As per DSI9361 JLM |  |

## Additional Product

Job Number:



|                |                              |                      |
|----------------|------------------------------|----------------------|
| <b>Seq. #:</b> | <b>Machine Or Operation:</b> | <b>Description :</b> |
|----------------|------------------------------|----------------------|

|     |    |                  |
|-----|----|------------------|
| 1.0 | DC | DOCUMENT CONTROL |
|-----|----|------------------|



**Comment:** DOCUMENT CONTROL JLD 08.6.11  
 Photocopy bluefile & type labels per PPPD206-540-011 CHG005

508/07/29

|     |             |                       |
|-----|-------------|-----------------------|
| 2.0 | PACKAGING 1 | PACKAGING RESOURCE #1 |
|-----|-------------|-----------------------|



**Comment:** PACKAGING RESOURCE #1  
 Pick: Assembly Kit

|     |        |                  |
|-----|--------|------------------|
| 3.0 | 39779A | 206L BASKET BASE |
|-----|--------|------------------|



**Comment:** Sub-Component 206L BASKET BASE  
 1 x D2252-041 Batch 39779A

508/07/24 @

|     |        |                 |
|-----|--------|-----------------|
| 4.0 | 39779B | 206L BASKET LID |
|-----|--------|-----------------|



**Comment:** Sub-Component 206L BASKET LID  
 1 x D2252-043 Batch 39779B

508/07/24 @

|     |          |                               |
|-----|----------|-------------------------------|
| 5.0 | D2332041 | Lid Prop Assembly 6.69" long. |
|-----|----------|-------------------------------|



**Comment:** Qty.: 1.0000 Each(s)/Unit Total: 1.0000 Each(s)  
 Pick: Assembly Kit  
 Qty Part Number Description Batch  
 1 D2332-041 Prop Ass'y 38797

508/07/24 @

| W/O: |      | WORK ORDER CHANGES |    |      |     |                                     |                          |
|------|------|--------------------|----|------|-----|-------------------------------------|--------------------------|
| DATE | STEP | PROCEDURE CHANGE   | By | Date | Qty | Approval<br>Chief Eng /<br>Prod Mgr | Approval<br>QC Inspector |
|      |      |                    |    |      |     |                                     |                          |
|      |      |                    |    |      |     |                                     |                          |

Part No: \_\_\_\_\_ PAR #: \_\_\_\_\_ Fault Category: \_\_\_\_\_ NCR: Yes No DQA: \_\_\_\_\_ Date: \_\_\_\_\_

QA: N/C Closed: \_\_\_\_\_ Date: \_\_\_\_\_

| NCR: |      | WORK ORDER NON-CONFORMANCE (NCR) |                             |                                 |                |                           |                       |                          |
|------|------|----------------------------------|-----------------------------|---------------------------------|----------------|---------------------------|-----------------------|--------------------------|
| DATE | STEP | Description of NC<br>Section A   | Corrective Action Section B |                                 |                | Verification<br>Section C | Approval<br>Chief Eng | Approval<br>QC Inspector |
|      |      |                                  | Initial<br>Chief Eng        | Action Description<br>Chief Eng | Sign &<br>Date |                           |                       |                          |
|      |      |                                  |                             |                                 |                |                           |                       |                          |
**NOTE:** Date & initial all entries

Date: Tuesday, 10/06/2008 12:53:56 PM  
User: Julie Lecocq

## Process Sheet

Customer: CU-DAR001 Dart Helicopters Services

Drawing Name: 206L UTILITY BASKET

Job Number: 39779

Part Number: D206540011

Job Number:



Seq. #:

Machine Or Operation:

Description :

6.0

D2022101

Spacer



Comment: Qty.: 2.0000 Each(s)/Unit Total : 2.0000 Each(s)

Pick: Assembly Kit

Qty Part Number Description Batch

2 D2022-101 SPACER

37521

SS

7.0

D2530

Handle Weldment



Comment: Qty.: 1.0000 Each(s)/Unit Total : 1.0000 Each(s)

Pick: Assembly Kit

Qty Part Number Description Batch

1 D2530 Handle Weldment

40211

SS

8.0

D2535

Spring



Comment: Qty.: 2.0000 Each(s)/Unit Total : 2.0000 Each(s)

Pick: Assembly Kit

Qty Part Number Description Batch

2 D2535 Spring

37071

SS

9.0

D2537

Bushing



Comment: Qty.: 2.0000 Each(s)/Unit Total : 2.0000 Each(s)

Pick: Assembly Kit

Qty Part Number Description Batch

2 D2537 Bushing

39153

SS

10.0

D2931

Bumper



Comment: Qty.: 4.0000 Each(s)/Unit Total : 4.0000 Each(s)

Pick: Assembly Kit

Qty Part Number Description Batch

4 D2931 Bumper

21139

SS

11.0

MS20600AD4W3

Cherry Rivets



Comment: Qty.: 4.0000 Each(s)/Unit Total : 4.0000 Each(s)

Pick: Assembly Kit

Qty Part Number Description Batch

4 MS20600AD4W3 Rivet

M18071

SS 08/01/24

| W/O: |      | WORK ORDER CHANGES |    |      |     |                                     |                          |
|------|------|--------------------|----|------|-----|-------------------------------------|--------------------------|
| DATE | STEP | PROCEDURE CHANGE   | By | Date | Qty | Approval<br>Chief Eng /<br>Prod Mgr | Approval<br>QC Inspector |
|      |      |                    |    |      |     |                                     |                          |
|      |      |                    |    |      |     |                                     |                          |

Part No: \_\_\_\_\_ PAR #: \_\_\_\_\_ Fault Category: \_\_\_\_\_ NCR: Yes No DQA: \_\_\_\_\_ Date: \_\_\_\_\_

QA: N/C Closed: \_\_\_\_\_ Date: \_\_\_\_\_

| NCR: |      | WORK ORDER NON-CONFORMANCE (NCR) |                             |                                 |                |                           |                       |                          |
|------|------|----------------------------------|-----------------------------|---------------------------------|----------------|---------------------------|-----------------------|--------------------------|
| DATE | STEP | Description of NC<br>Section A   | Corrective Action Section B |                                 |                | Verification<br>Section C | Approval<br>Chief Eng | Approval<br>QC Inspector |
|      |      |                                  | Initial<br>Chief Eng        | Action Description<br>Chief Eng | Sign &<br>Date |                           |                       |                          |
|      |      |                                  |                             |                                 |                |                           |                       |                          |
NOTE: Date & initial all entries

## Process Sheet

Customer: CU-DAR001 Dart Helicopters Services

Drawing Name: 206L UTILITY BASKET

Job Number: 39779

Part Number: D206540011

Job Number:



Seq. #:

Machine Or Operation:

Description :

12.0

AN47A

Bolt



Comment: Qty.: 2.0000 Each(s)/Unit Total : 2.0000 Each(s)

Pick: Assembly Kit

Qty Part Number Description Batch

2 AN4-7A Bolt M107321

JS

13.0

AN424A

Bolt



Comment: Qty.: 1.0000 Each(s)/Unit Total : 1.0000 Each(s)

Pick: Assembly Kit

Qty Part Number Description Batch

1 AN4-24A Bolt M164547

JS

14.0

AN316A

Bolt



Comment: Qty.: 2.0000 Each(s)/Unit Total : 2.0000 Each(s)

Pick: Assembly Kit

Qty Part Number Description Batch

2 AN3-16A Bolt M167737

JS

15.0

AN422A

Bolt



Comment: Qty.: 1.0000 Each(s)/Unit Total : 1.0000 Each(s)

Pick: Assembly Kit

Qty Part Number Description Batch

1 AN4-22A Bolt M167715

JS

16.0

AN517A

Bolt



Comment: Qty.: 4.0000 Each(s)/Unit Total : 4.0000 Each(s)

Pick: Assembly Kit

Qty Part Number Description Batch

4 AN5-17A Bolt M160815

JS

17.0

AN960JD416 L

Washer



Comment: Qty.: 4.0000 Each(s)/Unit Total : 4.0000 Each(s)

Pick: Assembly Kit

Qty Part Number Description Batch

4 AN960JD416L Washer M107939

JS 08/12/24

PW

Dart Aerospace Ltd

| W/O:     |      | WORK ORDER CHANGES                     |    |          |     |                                   |                          |
|----------|------|--|----|----------|-----|-----------------------------------|--------------------------|
| DATE     | STEP | PROCEDURE CHANGE                       | By | Date     | Qty | Approval<br>Chief Eng<br>Prod Mgr | Approval<br>QC Inspector |
| 08/07/24 | 172  | add 2 washers AN9605D416 L<br>M 108138 | EP | 08/07/24 | 2   | /08/14/24                         | S 08/07/24               |
|          |      |  |    |          |     |                                   |                          |

Part No: \_\_\_\_\_ PAR #: \_\_\_\_\_ Fault Category: \_\_\_\_\_ NCR: Yes No DQA: \_\_\_\_\_ Date: \_\_\_\_\_  
 QA: N/C Closed: \_\_\_\_\_ Date: \_\_\_\_\_

| NCR: |      | WORK ORDER NON-CONFORMANCE (NCR) |                             |                                 |                |                           |                       |                          |
|------|------|----------------------------------|-----------------------------|---------------------------------|----------------|---------------------------|-----------------------|--------------------------|
| DATE | STEP | Description of NC<br>Section A   | Corrective Action Section B |                                 |                | Verification<br>Section C | Approval<br>Chief Eng | Approval<br>QC Inspector |
|      |      |                                  | Initial<br>Chief Eng        | Action Description<br>Chief Eng | Sign &<br>Date |                           |                       |                          |
|      |      |                                  |                             |                                 |                |                           |                       |                          |
NOTE: Date & initial all entries

Date: Tuesday, 10/06/2008 12:53:56 PM  
User: Julie Lecocq

## Process Sheet

Customer: CU-DAR001 Dart Helicopters Services

Drawing Name: 206L UTILITY BASKET

Job Number: 39779

Part Number: D206540011

Job Number:



Seq. #:

Machine Or Operation:

Description :

18.0

AN960JD516

Washer



Comment: Qty.: 4.0000 Each(s)/Unit Total : 4.0000 Each(s)

Pick: Assembly Kit

Qty Part Number Description Batch

4 AN960JD516 Washer

M107959

JS

19.0

AN9704

Washer



Comment: Qty.: 4.0000 Each(s)/Unit Total : 4.0000 Each(s)

Pick: Assembly Kit

Qty Part Number Description Batch

4 AN970-4 Washer

M108077

JS

20.0

AN960JD8

Washer



Comment: Qty.: 4.0000 Each(s)/Unit Total : 4.0000 Each(s)

Pick: Assembly Kit

Qty Part Number Description Batch

4 AN960JD8 Washer

M107650

JS

21.0

MS21042L3

Nut



Comment: Qty.: 2.0000 Each(s)/Unit Total : 2.0000 Each(s)

Pick: Assembly Kit

Qty Part Number Description Batch

2 MS21042L3 Nut (or -3)

M107665

JS

22.0

MS21042L4

Nut



Comment: Qty.: 4.0000 Each(s)/Unit Total : 4.0000 Each(s)

Pick: Assembly Kit

Qty Part Number Description Batch

4 MS21042L4 Nut (or -4)

M107478

JS 08/07/24

| W/O: |      | WORK ORDER CHANGES |    |      |     |                                     |                          |
|------|------|--------------------|----|------|-----|-------------------------------------|--------------------------|
| DATE | STEP | PROCEDURE CHANGE   | By | Date | Qty | Approval<br>Chief Eng /<br>Prod Mgr | Approval<br>QC Inspector |
|      |      |                    |    |      |     |                                     |                          |
|      |      |                    |    |      |     |                                     |                          |

Part No: \_\_\_\_\_ PAR #: \_\_\_\_\_ Fault Category: \_\_\_\_\_ NCR: Yes No DQA: \_\_\_\_\_ Date: \_\_\_\_\_

QA: N/C Closed: \_\_\_\_\_ Date: \_\_\_\_\_

| NCR: |      | WORK ORDER NON-CONFORMANCE (NCR) |                             |                                 |                |                           |                       |                          |
|------|------|----------------------------------|-----------------------------|---------------------------------|----------------|---------------------------|-----------------------|--------------------------|
| DATE | STEP | Description of NC<br>Section A   | Corrective Action Section B |                                 |                | Verification<br>Section C | Approval<br>Chief Eng | Approval<br>QC Inspector |
|      |      |                                  | Initial<br>Chief Eng        | Action Description<br>Chief Eng | Sign &<br>Date |                           |                       |                          |
|      |      |                                  |                             |                                 |                |                           |                       |                          |
**NOTE:** Date & initial all entries



Date: Tuesday, 10/06/2008 12:53:56 PM  
User: Julie Lecocq

## Process Sheet

Customer: CU-DAR001 Dart Helicopters Services

Drawing Name: 206L UTILITY BASKET

Job Number: 39779

Part Number: D206540011

Job Number:



Seq. #:

Machine Or Operation:

Description :

23.0

D2258170

Label - 170 lb



Comment: Qty.: 1.0000 Each(s)/Unit Total : 1.0000 Each(s)

Pick: Packing Kit

1 D2258-170 PLACARD

16269

SS

24.0

MS21042L5

Nut



Comment: Qty.: 4.0000 Each(s)/Unit Total : 4.0000 Each(s)

Pick: Assembly Kit

Qty Part Number Description Batch

4 MS21042L5

Nut (or -5)

M167939

SS

25.0

D27283

Dart Logo Label - large



Comment: Qty.: 2.0000 Each(s)/Unit Total : 2.0000 Each(s)

Dart Logo label large

Batch: 22553

SS 08/09/24

26.0

SMALL FAB 1

SMALL & MEDIUM FAB RESOURCE 1



Comment: SMALL & MEDIUM FAB RESOURCE 1

Assemble as per Dwg D206-540

08/07/24 @

27.0

QC5

INSPECT WORK TO CURRENT STEP



Comment: INSPECT WORK TO CURRENT STEP

08/07/24 (H)

28.0

PACKAGING 1

PACKAGING RESOURCE #1



Comment: PACKAGING RESOURCE #1

Pick: Packing Kit

29.0

D2249041

Fitting Assembly



Comment: Qty.: 2.0000 Each(s)/Unit Total : 2.0000 Each(s)

Pick: Packing Kit

2 d2249-041 bracket

1340486

8/7/29

SC

\* 08/07/24

2

| W/O: |      | WORK ORDER CHANGES |    |      |     |                                     |                          |
|------|------|--------------------|----|------|-----|-------------------------------------|--------------------------|
| DATE | STEP | PROCEDURE CHANGE   | By | Date | Qty | Approval<br>Chief Eng /<br>Prod Mgr | Approval<br>QC Inspector |
|      |      |                    |    |      |     |                                     |                          |
|      |      |                    |    |      |     |                                     |                          |

Part No: \_\_\_\_\_ PAR #: \_\_\_\_\_ Fault Category: \_\_\_\_\_ NCR: Yes No DQA: \_\_\_\_\_ Date: \_\_\_\_\_

QA: N/C Closed: \_\_\_\_\_ Date: \_\_\_\_\_

| NCR: |      | WORK ORDER NON-CONFORMANCE (NCR) |                             |                                 |                |                           |                       |                          |
|------|------|----------------------------------|-----------------------------|---------------------------------|----------------|---------------------------|-----------------------|--------------------------|
| DATE | STEP | Description of NC<br>Section A   | Corrective Action Section B |                                 |                | Verification<br>Section C | Approval<br>Chief Eng | Approval<br>QC Inspector |
|      |      |                                  | Initial<br>Chief Eng        | Action Description<br>Chief Eng | Sign &<br>Date |                           |                       |                          |
|      |      |                                  |                             |                                 |                |                           |                       |                          |
NOTE: Date & initial all entries

Date: Tuesday, 10/06/2008 12:53:56 PM  
User: Julie Lecocq

## Process Sheet

Customer: CU-DAR001 Dart Helicopters Services

Drawing Name: 206L UTILITY BASKET

Job Number: 39779

Part Number: D206540011

Job Number:



Seq. #:

Machine Or Operation:

Description :

30.0

D33963

Spacer



Comment: Qty.: 4.0000 Each(s)/Unit Total : 4.0000 Each(s)

Spacer

Batch: 36336

31.0

D2259

Label



Comment: Qty.: 1.0000 Each(s)/Unit Total : 1.0000 Each(s)

Pick: Packing Kit

1 D2259 Placard 10671

32.0

D2525

Spacer



Comment: Qty.: 2.0000 Each(s)/Unit Total : 2.0000 Each(s)

Pick: Packing Kit

2 D2525 Spacer kit 34506

33.0

D2526

Bushing



Comment: Qty.: 2.0000 Each(s)/Unit Total : 2.0000 Each(s)

Pick: Packing Kit

2 D2526 Bushing 27555

34.0

D2537

Bushing



Comment: Qty.: 2.0000 Each(s)/Unit Total : 2.0000 Each(s)

Pick: Packing Kit

2 D2537 BUSHING 39153

35.0

D2748

Clevis



Comment: Qty.: 2.0000 Each(s)/Unit Total : 2.0000 Each(s)

Pick: Packing Kit

2 D2748 Clevis 34511

36.0

D27495

Strut



Comment: Qty.: 1.0000 Each(s)/Unit Total : 1.0000 Each(s)

Pick: Packing Kit

1 D2749-5 Strut 24157

08/07/23 (K)

| W/O: |      | WORK ORDER CHANGES |    |      |     |                                     |                          |
|------|------|--------------------|----|------|-----|-------------------------------------|--------------------------|
| DATE | STEP | PROCEDURE CHANGE   | By | Date | Qty | Approval<br>Chief Eng /<br>Prod Mgr | Approval<br>QC Inspector |
|      |      |                    |    |      |     |                                     |                          |
|      |      |                    |    |      |     |                                     |                          |

Part No: \_\_\_\_\_ PAR #: \_\_\_\_\_ Fault Category: \_\_\_\_\_ NCR: Yes No DQA: \_\_\_\_\_ Date: \_\_\_\_\_

QA: N/C Closed: \_\_\_\_\_ Date: \_\_\_\_\_

| NCR: |      | WORK ORDER NON-CONFORMANCE (NCR) |                             |                                 |                |                           |                       |                          |
|------|------|----------------------------------|-----------------------------|---------------------------------|----------------|---------------------------|-----------------------|--------------------------|
| DATE | STEP | Description of NC<br>Section A   | Corrective Action Section B |                                 |                | Verification<br>Section C | Approval<br>Chief Eng | Approval<br>QC Inspector |
|      |      |                                  | Initial<br>Chief Eng        | Action Description<br>Chief Eng | Sign &<br>Date |                           |                       |                          |
|      |      |                                  |                             |                                 |                |                           |                       |                          |
NOTE: Date & initial all entries

Date: Tuesday, 10/06/2008 12:53:56 PM  
User: Julie Lecocq

## Process Sheet

Customer: CU-DAR001 Dart Helicopters Services

Drawing Name: 206L UTILITY BASKET

Job Number: 39779

Part Number: D206540011

Job Number:



Seq. #:

Machine Or Operation:

Description :

37.0

D27497

Strut



Comment: Qty.: 1.0000 Each(s)/Unit Total : 1.0000 Each(s)

Pick: Packing Kit

1 D2749-7 Strut

26887

38.0

AN421A

Bolt



Comment: Qty.: 2.0000 Each(s)/Unit Total : 2.0000 Each(s)

Pick: Packing Kit

2 AN4-21A Bolt

M11695

39.0

AN45A

Bolt



Comment: Qty.: 8.0000 Each(s)/Unit Total : 8.0000 Each(s)

Pick: Packing Kit

8 AN4-5A Bolt

M106605

40.0

AN412A

Bolt



Comment: Qty.: 2.0000 Each(s)/Unit Total : 2.0000 Each(s)

Pick: Packing Kit

2 AN4-12A Bolt

M105143

41.0

AN517A

Bolt



Comment: Qty.: 2.0000 Each(s)/Unit Total : 2.0000 Each(s)

Pick: Packing Kit

2 AN5-17A Bolt

M166815

42.0

AN960JD416

Washer



Comment: Qty.: 12.0000 Each(s)/Unit Total : 12.0000 Each(s)

Pick: Packing Kit

Qty Part Number Description Batch

12 AN960JD416 Washer

M167939

08/07/23 (K)

| W/O: |      | WORK ORDER CHANGES |    |      |     |                                     |                          |
|------|------|--------------------|----|------|-----|-------------------------------------|--------------------------|
| DATE | STEP | PROCEDURE CHANGE   | By | Date | Qty | Approval<br>Chief Eng /<br>Prod Mgr | Approval<br>QC Inspector |
|      |      |                    |    |      |     |                                     |                          |
|      |      |                    |    |      |     |                                     |                          |

Part No: \_\_\_\_\_ PAR #: \_\_\_\_\_ Fault Category: \_\_\_\_\_ NCR: Yes No DQA: \_\_\_\_\_ Date: \_\_\_\_\_

QA: N/C Closed: \_\_\_\_\_ Date: \_\_\_\_\_

| NCR: |      | WORK ORDER NON-CONFORMANCE (NCR) |                             |                                 |                |                           |                       |                          |
|------|------|----------------------------------|-----------------------------|---------------------------------|----------------|---------------------------|-----------------------|--------------------------|
| DATE | STEP | Description of NC<br>Section A   | Corrective Action Section B |                                 |                | Verification<br>Section C | Approval<br>Chief Eng | Approval<br>QC Inspector |
|      |      |                                  | Initial<br>Chief Eng        | Action Description<br>Chief Eng | Sign &<br>Date |                           |                       |                          |
|      |      |                                  |                             |                                 |                |                           |                       |                          |
NOTE: Date & initial all entries

Date: Tuesday, 10/06/2008 12:53:56 PM  
User: Julie Lecocq

## Process Sheet

Customer: CU-DAR001 Dart Helicopters Services

Drawing Name: 206L UTILITY BASKET

Job Number: 39779

Part Number: D206540011

Job Number:



Seq. #:

Machine Or Operation:

Description :

43.0

AN960JD516

Washer



Comment: Qty.: 2.0000 Each(s)/Unit Total : 2.0000 Each(s)

Pick: Packing Kit

2 AN960JD516 Washer

M167959

44.0

MS21042L4

Nut



Comment: Qty.: 4.0000 Each(s)/Unit Total : 4.0000 Each(s)

Pick: Packing Kit

Qty Part Number Description Batch

4 MS21042L4 Nut (or -4)

M167478

45.0

MS21042L5

Nut



Comment: Qty.: 2.0000 Each(s)/Unit Total : 2.0000 Each(s)

Pick: Packing Kit

2 MS21042L5 Nut

M167939

46.0

QC4

INSPECT 100% KITS FOR COMPLETENESS



Comment: INSPECT 100% KITS FOR COMPLETENESS

47.0

PACKAGING 1

PACKAGING RESOURCE #1



Comment: PACKAGING RESOURCE #1

Identify and pack for shipping as per PPP D206-540-011

Location: RD

PPP Rev: H

8/7/29

Q

Scd

48.0

QC21

FINAL INSPECTION/W/O RELEASE



Comment: FINAL INSPECTION/W/O RELEASE

08/07/30

Job Completion



mf 08-07-30



| W/O: |      | WORK ORDER CHANGES |    |      |     |                                     |                          |
|------|------|--------------------|----|------|-----|-------------------------------------|--------------------------|
| DATE | STEP | PROCEDURE CHANGE   | By | Date | Qty | Approval<br>Chief Eng /<br>Prod Mgr | Approval<br>QC Inspector |
|      |      |                    |    |      |     |                                     |                          |
|      |      |                    |    |      |     |                                     |                          |

Part No: \_\_\_\_\_ PAR #: \_\_\_\_\_ Fault Category: \_\_\_\_\_ NCR: Yes No DQA: \_\_\_\_\_ Date: \_\_\_\_\_

QA: N/C Closed: \_\_\_\_\_ Date: \_\_\_\_\_

| NCR: |      | WORK ORDER NON-CONFORMANCE (NCR) |                             |                                 |                |                           |                       |                          |
|------|------|----------------------------------|-----------------------------|---------------------------------|----------------|---------------------------|-----------------------|--------------------------|
| DATE | STEP | Description of NC<br>Section A   | Corrective Action Section B |                                 |                | Verification<br>Section C | Approval<br>Chief Eng | Approval<br>QC Inspector |
|      |      |                                  | Initial<br>Chief Eng        | Action Description<br>Chief Eng | Sign &<br>Date |                           |                       |                          |
|      |      |                                  |                             |                                 |                |                           |                       |                          |
**NOTE:** Date & initial all entries





|                               |                                |   |                        |
|-------------------------------|--------------------------------|---|------------------------|
| DESIGN<br><b>CB</b>           | DRAWN BY<br><b>CB</b>          | DART AEROSPACE LTD<br>HAWKESBURY, ONTARIO, CANADA |                        |
| CHECKED<br><i>[Signature]</i> | APPROVED<br><i>[Signature]</i> | DRAWING NO.<br>DSI 9361                           | REV. A<br>SHEET 1 OF 1 |
| DATE<br>07.03.15              |                                | TITLE<br>UTILITY BASKET SPACER                    | SCALE<br>NTS           |
| A                             | 07.03.15                       | NEW ISSUE   |                        |


## DART SERVICE INSTRUCTION

TO AMEND DART INSTALLATION DRAWING D206-540 REV. I  
REF. CANADIAN STC: SH94-5  
REF. FAA STC: SR00386NY


The following parts will be **added** to the Parts List on page 1 of Installation Drawing D206-540.

| Qty -<br>011 | Qty -<br>013 | Part No.     | Description                         |
|--------------|--------------|--------------|-------------------------------------|
| X            |              | D206-540-011 | BASKET INSTL'N - BELL 206L/L1/L3/L4 |
|              | X            | D206-540-013 | BASKET INSTL'N - BELL 206A/B        |
| 4            | 4            | D3396-3      | SPACER                              |


Install qty(2) D3396-3 Spacers per strut at the location shown in **Figure 1** (for D206-540-011 kit) and **Figure 2** (for D206-540-013 kit). Install hardware per View A-A

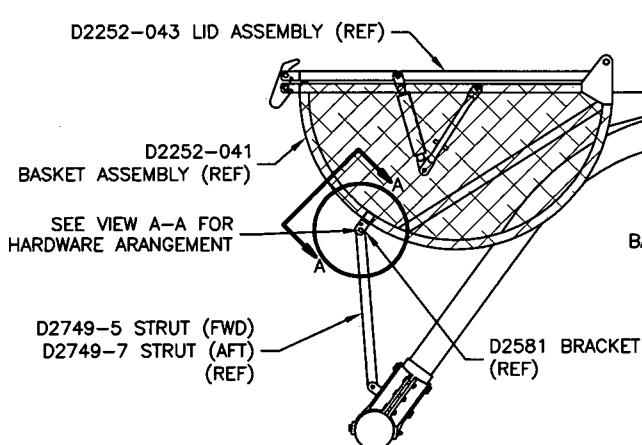

**FIGURE 1 - D206-540-011  
INSTALLATION**

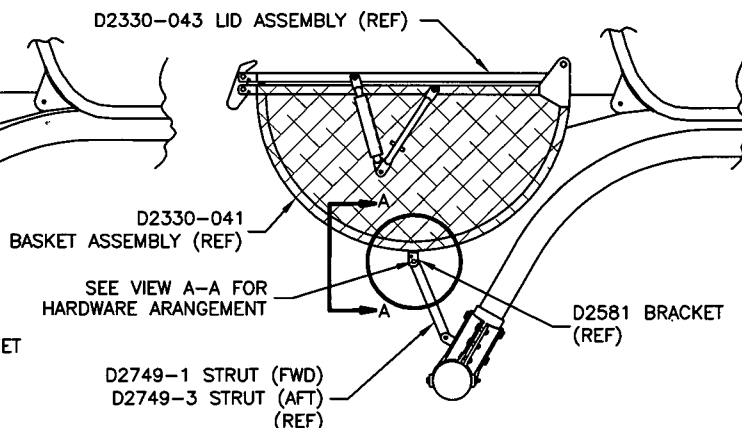

**FIGURE 2 - D206-540-013  
INSTALLATION**

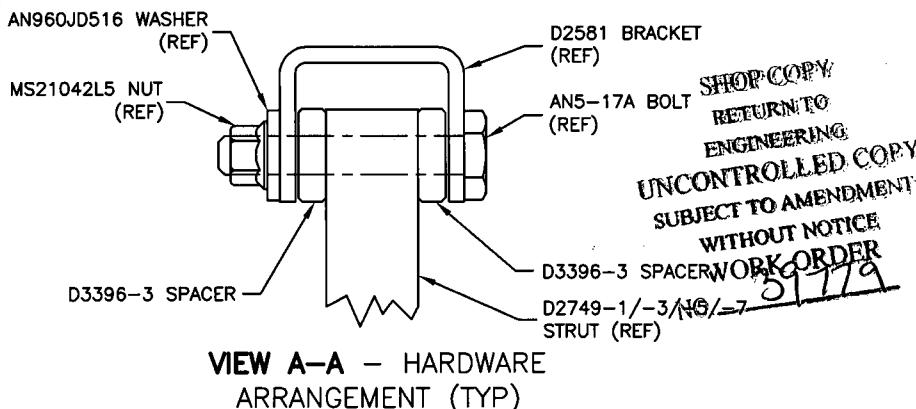

**VIEW A-A - HARDWARE  
ARRANGEMENT (TYP)**

CANADA  
DEPARTMENT OF TRANSPORT  
AIRCRAFT CERTIFICATION  
BRANCH  
DAO # 01-O-01

**APPROVED**

BY: *[Signature]*  
D. SHEPHERD (DE # 02)

DATE: 07.03.15  
CERT. NO.: SH94-5  
ISSUE NO.: 4

Copyright © 2007 by DART AEROSPACE LTD

THIS DOCUMENT IS PRIVATE AND CONFIDENTIAL AND IS SUPPLIED ON THE EXPRESS CONDITION THAT IT IS NOT TO BE USED FOR ANY PURPOSE OR COPIED OR COMMUNICATED TO ANY OTHER PERSON WITHOUT WRITTEN PERMISSION FROM DART AEROSPACE LTD.

Date: Tuesday, 10/06/2008 12:54:05 PM  
 User: Julie Lecocq

## Process Sheet

|                                    |   |                           |                  |
|------------------------------------|---|---------------------------|------------------|
| <b>Customer</b> :                  | CU-DAR001 Dart Helicopters Services         | <b>Drawing Name</b> :     | 206L BASKET BASE |
| <b>Job Number</b> :                | 39779A                                      |                           |                  |
| <b>Estimate Number</b> :           | 11273                                       |                           |                  |
| <b>P.O. Number</b> :               |   | <b>Part Number</b> :      | D2252041         |
| <b>This Issue</b> :                | 10/06/2008                                  | <b>S.O. No.</b> :         |                  |
| <b>Prsht Rev.</b> :                | NC  | <b>Drawing Number</b> :   | D2252 REV E      |
| <b>First Issue</b> :               | / /   | <b>Project Number</b> :   | N/A              |
| <b>Previous Run</b> :              | 36655A                                      | <b>Drawing Revision</b> : | E                |
| <b>Written By</b> :                |   | <b>Material</b> :         |                  |
| <b>Checked &amp; Approved By</b> : | JLD 08.6.10                                 | <b>Due Date</b> :         | 30/06/2008       |
| <b>Comment</b> :                   | Est Rev:1 Revised as per Rev E 05-12-06 JLM |                           |                  |

Qty: 1 Um: Each

## Additional Product

Job Number:



|                |                              |                      |
|----------------|------------------------------|----------------------|
| <b>Seq. #:</b> | <b>Machine Or Operation:</b> | <b>Description :</b> |
|----------------|------------------------------|----------------------|

|     |        |             |
|-----|--------|-------------|
| 1.0 | D31661 | Basket Hoop |
|-----|--------|-------------|



Comment: Qty.: 5.0000 Each(s)/Unit Total : 5.0000 Each(s)

Pick:

|     |         |             |         |
|-----|---------|-------------|---------|
| Qty | Part#   | Description | Batch   |
| 5   | D3166-1 | Hoop        | B 40090 |

SAD 08/07/10

|     |                |                          |
|-----|----------------|--------------------------|
| 2.0 | M304TS0750W065 | 304 SQ Tube.75x.75x.065W |
|-----|----------------|--------------------------|



Comment: Qty.: 25.0000 f(s)/Unit Total : 25.0000 f(s)

3/4" x 3/4" x 0.063 wall 304/316 SS tubing.

Batch: M108250

SAD 08/07/09 ①

|     |             |                              |
|-----|-------------|------------------------------|
| 3.0 | LARGE FAB 1 | LARGE FABRICATION RESOURCE 1 |
|-----|-------------|------------------------------|



Comment: LARGE FABRICATION RESOURCE 1

1-Cut Rib from 3/4" x 3/4" x 0.063 wall 304/316 SS tubing.

Cut 5 D2235-1 From D3166-1

2- Cut Ribs as per Dwg D2252

3-Drill hole in D2252-1as per Dwg D2252

4-Deburr & Remove all Markings from Material

SAD 08/07/10 ①

|     |        |     |
|-----|--------|-----|
| 4.0 | D22531 | Lug |
|-----|--------|-----|



Comment: Qty.: 2.0000 Each(s)/Unit Total : 2.0000 Each(s)

Pick:

|     |             |             |         |
|-----|-------------|-------------|---------|
| Qty | Part Number | Description | Batch   |
| 2   | D2253       | Gusset      | B 35685 |

SAD 08/07/10

| W/O: |      | WORK ORDER CHANGES |    |      |     |                                     |                          |
|------|------|--------------------|----|------|-----|-------------------------------------|--------------------------|
| DATE | STEP | PROCEDURE CHANGE   | By | Date | Qty | Approval<br>Chief Eng /<br>Prod Mgr | Approval<br>QC Inspector |
|      |      |                    |    |      |     |                                     |                          |
|      |      |                    |    |      |     |                                     |                          |

Part No: \_\_\_\_\_ PAR #: \_\_\_\_\_ Fault Category: \_\_\_\_\_ NCR: Yes No DQA: \_\_\_\_\_ Date: \_\_\_\_\_

QA: N/C Closed: \_\_\_\_\_ Date: \_\_\_\_\_

| NCR: |      | WORK ORDER NON-CONFORMANCE (NCR) |                             |                                 |                |                           |                       |                          |
|------|------|----------------------------------|-----------------------------|---------------------------------|----------------|---------------------------|-----------------------|--------------------------|
| DATE | STEP | Description of NC<br>Section A   | Corrective Action Section B |                                 |                | Verification<br>Section C | Approval<br>Chief Eng | Approval<br>QC Inspector |
|      |      |                                  | Initial<br>Chief Eng        | Action Description<br>Chief Eng | Sign &<br>Date |                           |                       |                          |
|      |      |                                  |                             |                                 |                |                           |                       |                          |
NOTE: Date & initial all entries

Date: Tuesday, 10/06/2008 12:54:05 PM  
User: Julie Lecocq

## Process Sheet

Customer: CU-DAR001 Dart Helicopters Services

Drawing Name: 206L BASKET BASE

Job Number: 39779A

Part Number: D2252041

Job Number:



Seq. #:

Machine Or Operation:

Description :

5.0

D23273

Spacer Bushing



Comment: Qty.: 1.0000 Each(s)/Unit Total : 1.0000 Each(s)

Pick:

Qty Part Number Description Batch

1 D2327-3 Bushing B37541

*JS* 08/07/16

6.0

D2581

Mounting Bracket



Comment: Qty.: 4.0000 Each(s)/Unit Total : 4.0000 Each(s)

Pick:

Qty Part Number Description Batch

4 D2581 Mounting Chamel B39046

*JS* 08/07/16

7.0

D2254

Gussett



Comment: Qty.: 2.0000 Each(s)/Unit Total : 2.0000 Each(s)

Pick:

Qty Part Number Description Batch

2 D2254 Lug B23421

*JS* 08/07/16

8.0

D22323

Basket Hinge



Comment: Qty.: 2.0000 Each(s)/Unit Total : 2.0000 Each(s)

Pick:

Qty Part Number Description Batch

2 D2232-3 HINGE B39334

*JS* 08/07/16

9.0

M304EX07516F

Expanded Metal Flat Stai



Comment: Qty.: 33.6000 sf(s)/Unit Total : 33.6000 sf(s)

Pick:

Qty Part Number Description Batch

32 sf M304EX0.75-16F Expanded Metal 108474 (256) 108152 (8)

SAD 08/07/14 @

10.0

LARGE FAB 1

LARGE FABRICATION RESOURCE 1



Comment: LARGE FABRICATION RESOURCE 1

1-Weld as per Dwg D2252 using Welding Table and corner Jig Debur as required

A/R SS ROD Batch: M106762

M107051

*JS* 08/07/22

*JS* 08/07/16

| W/O: |      | WORK ORDER CHANGES |    |      |     |                                     |                          |
|------|------|--------------------|----|------|-----|-------------------------------------|--------------------------|
| DATE | STEP | PROCEDURE CHANGE   | By | Date | Qty | Approval<br>Chief Eng /<br>Prod Mgr | Approval<br>QC Inspector |
|      |      |                    |    |      |     |                                     |                          |
|      |      |                    |    |      |     |                                     |                          |

Part No: \_\_\_\_\_ PAR #: \_\_\_\_\_ Fault Category: \_\_\_\_\_ NCR: Yes No DQA: \_\_\_\_\_ Date: \_\_\_\_\_

QA: N/C Closed: \_\_\_\_\_ Date: \_\_\_\_\_

| NCR: |      | WORK ORDER NON-CONFORMANCE (NCR) |                                |                                 |                |                           |                       |                          |
|------|------|----------------------------------|--------------------------------|---------------------------------|----------------|---------------------------|-----------------------|--------------------------|
| DATE | STEP | Description of NC<br>Section A   | Corrective Action<br>Section B |                                 |                | Verification<br>Section C | Approval<br>Chief Eng | Approval<br>QC Inspector |
|      |      |                                  | Initial<br>Chief Eng           | Action Description<br>Chief Eng | Sign &<br>Date |                           |                       |                          |
|      |      |                                  |                                |                                 |                |                           |                       |                          |
NOTE: Date & initial all entries

Date: Tuesday, 10/06/2008 12:54:05 PM  
User: Julie Lecocq

## Process Sheet

Customer: CU-DAR001 Dart Helicopters Services

Drawing Name: 206L BASKET BASE

Job Number: 39779A

Part Number: D2252041

Job Number:



Seq. #:

Machine Or Operation:

Description :

11.0

QC9

VISUAL WELDING INSPECTION



Comment: VISUAL WELDING INSPECTION

PD 08-07-23

12.0

QC5

INSPECT WORK TO CURRENT STEP



Comment: INSPECT WORK TO CURRENT STEP

S 08/07/23 @

13.0

POWDER COATING

POWDER COATING



M108523



(1X)

Comment: POWDER COATING

Powder Coat White Gloss (Ref: 4.3.5.1) as per QSI 005 4.3

START TIME:

OVEN TEMPERATURE:

FINISH TIME:

1:10 OF  
4:00  
1:40

MF 08/07/23

14.0

QC3

INSPECT POWDER COAT/CHEMICAL CONVERSION



Comment: INSPECT POWDER COAT/CHEMICAL CONVERSION

HL 08-07-23 @

15.0

PACKAGING 1

PACKAGING RESOURCE #



Comment: PACKAGING RESOURCE #1

Identify and Stock

Location:

G-A

EP 08/07/24 @

16.0

QC21

FINAL INSPECTION/W/O RELEASE



Comment: FINAL INSPECTION/W/O RELEASE

08/07/30 @

Job Completion



MF 08-07-30

| W/O: |      | WORK ORDER CHANGES |    |      |     |                                     |                          |
|------|------|--------------------|----|------|-----|-------------------------------------|--------------------------|
| DATE | STEP | PROCEDURE CHANGE   | By | Date | Qty | Approval<br>Chief Eng /<br>Prod Mgr | Approval<br>QC Inspector |
|      |      |                    |    |      |     |                                     |                          |
|      |      |                    |    |      |     |                                     |                          |

Part No: \_\_\_\_\_ PAR #: \_\_\_\_\_ Fault Category: \_\_\_\_\_ NCR: Yes No DQA: \_\_\_\_\_ Date: \_\_\_\_\_

QA: N/C Closed: \_\_\_\_\_ Date: \_\_\_\_\_

| NCR: |      | WORK ORDER NON-CONFORMANCE (NCR) |                             |                                 |                |                           |                       |                          |
|------|------|----------------------------------|-----------------------------|---------------------------------|----------------|---------------------------|-----------------------|--------------------------|
| DATE | STEP | Description of NC<br>Section A   | Corrective Action Section B |                                 |                | Verification<br>Section C | Approval<br>Chief Eng | Approval<br>QC Inspector |
|      |      |                                  | Initial<br>Chief Eng        | Action Description<br>Chief Eng | Sign &<br>Date |                           |                       |                          |
|      |      |                                  |                             |                                 |                |                           |                       |                          |
**NOTE:** Date & initial all entries


**DART****RELEASED**  
05.11.26

|                     |                       |  |                        |
|---------------------|-----------------------|--|------------------------|
| DESIGN<br><b>KE</b> | DRAWN BY<br><b>MB</b> | <b>DART AEROSPACE LTD</b><br>HAWKESBURY, ONTARIO, CANADA                                   |                        |
| CHECKED<br><b>#</b> | APPROVED<br><b>#</b>  | DRAWING NO.<br>D2252   | REV. E<br>SHEET 1 OF 5 |
| DATE<br>05.11.10    |                       | TITLE<br>BASKET ASSEMBLY (206L)  | SCALE<br>NTS           |
| C                   | 95.12.11              | RE-DRAWN   |                        |
| D                   | 99.09.14              | MODIFIED LATCH, D2581 WAS D2255-3  |                        |
| E                   | 05.11.10              | D2253-1 WAS D2253 (NCR 533),<br>ADDED MEMBERS TO LID FRAME,<br>ADDED D2232-1/-3 & D2252-19 |                        |

| Qty<br>-041 | Qty<br>-043 | Part Number | Description            | L     | A  |
|-------------|-------------|-------------|------------------------|-------|----|
| X           |             | D2252-041   | BASKET ASSEMBLY        |       |    |
|             | X           | D2252-043   | LID ASSEMBLY           |       |    |
|             | 2           | D2232-1     | HINGE                  |       |    |
| 2           |             | D2232-3     | HINGE                  |       |    |
| 5           |             | D2235-1     | RIB                    |       |    |
| 2           | 2           | D2252-1     | FRAME                  | 25.50 | 45 |
| 2           |             | D2252-3     | FRAME                  | 96.00 | 45 |
|             | 2           | D2252-7     | FRAME                  | 24.00 | 90 |
| 1           |             | D2252-9     | FRAME                  | 10.25 | 90 |
| 1           |             | D2252-11    | FRAME                  | 25.00 | 90 |
| 1           |             | D2252-13    | FRAME                  | 42.00 | 90 |
| 1           |             | D2252-15    | FRAME                  | 15.00 | 90 |
| 4           |             | D2252-17    | FRAME                  | 19.78 | 53 |
|             | 2           | D2252-19    | FRAME                  | 95.27 | 45 |
|             | 2           | D2252-21    | FRAME                  | 30.82 | 90 |
|             | 1           | D2252-23    | FRAME                  | 30.62 | 90 |
| 2           |             | D2253-1     | LUG                    |       |    |
| 2           |             | D2254       | GUSSET                 |       |    |
|             | 1           | D2327-1     | BUSHING                |       |    |
| 1           |             | D2327-3     | BUSHING                |       |    |
|             | 1           | D2329       | LABEL PLATE            |       |    |
| 4           | 2           | D2581       | MOUNTING CHANNEL       |       |    |
| A/R         | A/R         |             | 3/4-16F EXPANDED METAL |       |    |

**NOTES:**

- 0.065 ~~0.060~~ 08.06.10
- MATERIAL: AISI 304/316 SS 3/4 X 3/4 X (0.060) WALL SQUARE TUBE  
(REF. DART SPEC. M304TS0.750W.060)
  - FINISH: POWDER COAT ASSEMBLY GLOSS WHITE (4.3.5.2) PER DART QSI 005 4.3
  - WELD PER DART QSI 004
  - ALL DIMENSION ARE IN INCHES
  - TOLERANCES ARE PER DART QSI 018 UNLESS OTHERWISE NOTED.

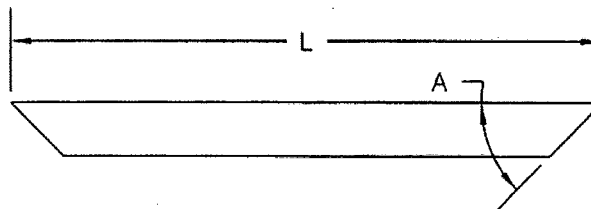**CUT SIZE DETAIL**

**UNDER REVIEW**  
08.06.10  
TUBING TO SHOP COPY  
CHANGED TO RETURN TO  
WALL ENGINEERING  
UNCONTROLLED COPY  
SUBJECT TO AMENDMENT  
WITHOUT NOTICE  
WORK ORDER  
NO. 3977917


**Copyright © 1994 by DART AEROSPACE LTD**

THIS DOCUMENT IS PRIVATE AND CONFIDENTIAL AND IS SUPPLIED ON THE EXPRESS CONDITION THAT IT IS NOT TO BE USED FOR ANY PURPOSE OR COPIED OR COMMUNICATED TO ANY OTHER PERSON WITHOUT WRITTEN PERMISSION FROM DART AEROSPACE LTD.



RELEASED  
05.11.26

**UNDER REVIEW**  
08-02-06 #1  
TUBING TO BE  
CHANGED TO 0.065  
WALL  
#1  
01.06.10

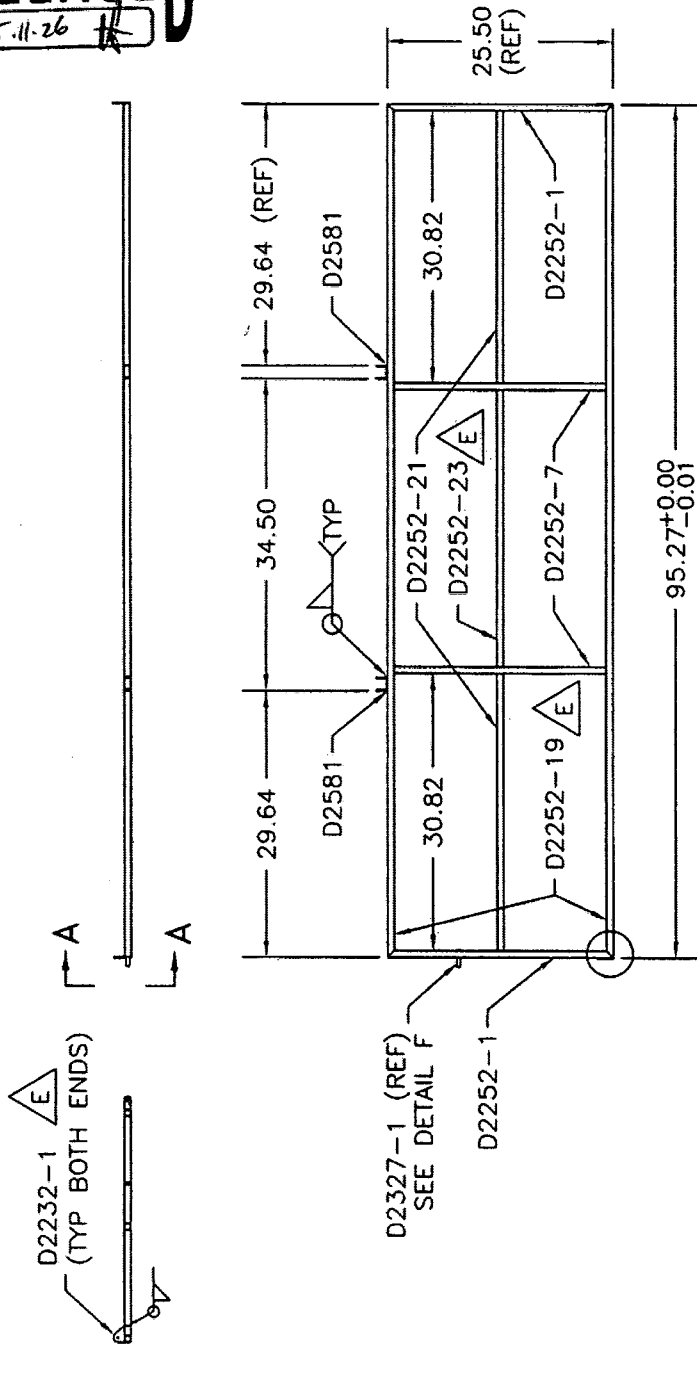

D2252-043 LID FRAME

WELD ALL JOINTS  
AS SHOWN


SHOP COPY  
RETURN TO  
ENGINEERING  
UNCONTROLLED COPY  
SUBJECT TO AMENDMENT  
WITHOUT NOTICE  
WORK ORDER  
NO. 397794

Copyright © 1994 by DART AEROSPACE LTD

THIS DOCUMENT IS PRIVATE AND CONFIDENTIAL AND IS SUPPLIED ON THE EXPRESS CONDITION THAT IT IS NOT TO BE USED FOR ANY PURPOSE OR COPIED OR COMMUNICATED TO ANY OTHER PERSON WITHOUT WRITTEN PERMISSION FROM DART AEROSPACE LTD.

# DART

|                               |                                 |   |                        |
|-------------------------------|---------------------------------|---|------------------------|
| DESIGN<br>KE                  | DRAWN BY<br>MB                  | DART AEROSPACE LTD<br>HAWKESBURY, ONTARIO, CANADA |                        |
| CHECKED<br><i>[Signature]</i> | APPROVED<br><i>[Signature]</i>  | DRAWING NO.<br>D2252                              | REV. E<br>SHEET 3 OF 5 |
| DATE<br>05.11.10              | TITLE<br>BASKET ASSEMBLY (206L) |   | SCALE<br>NTS           |

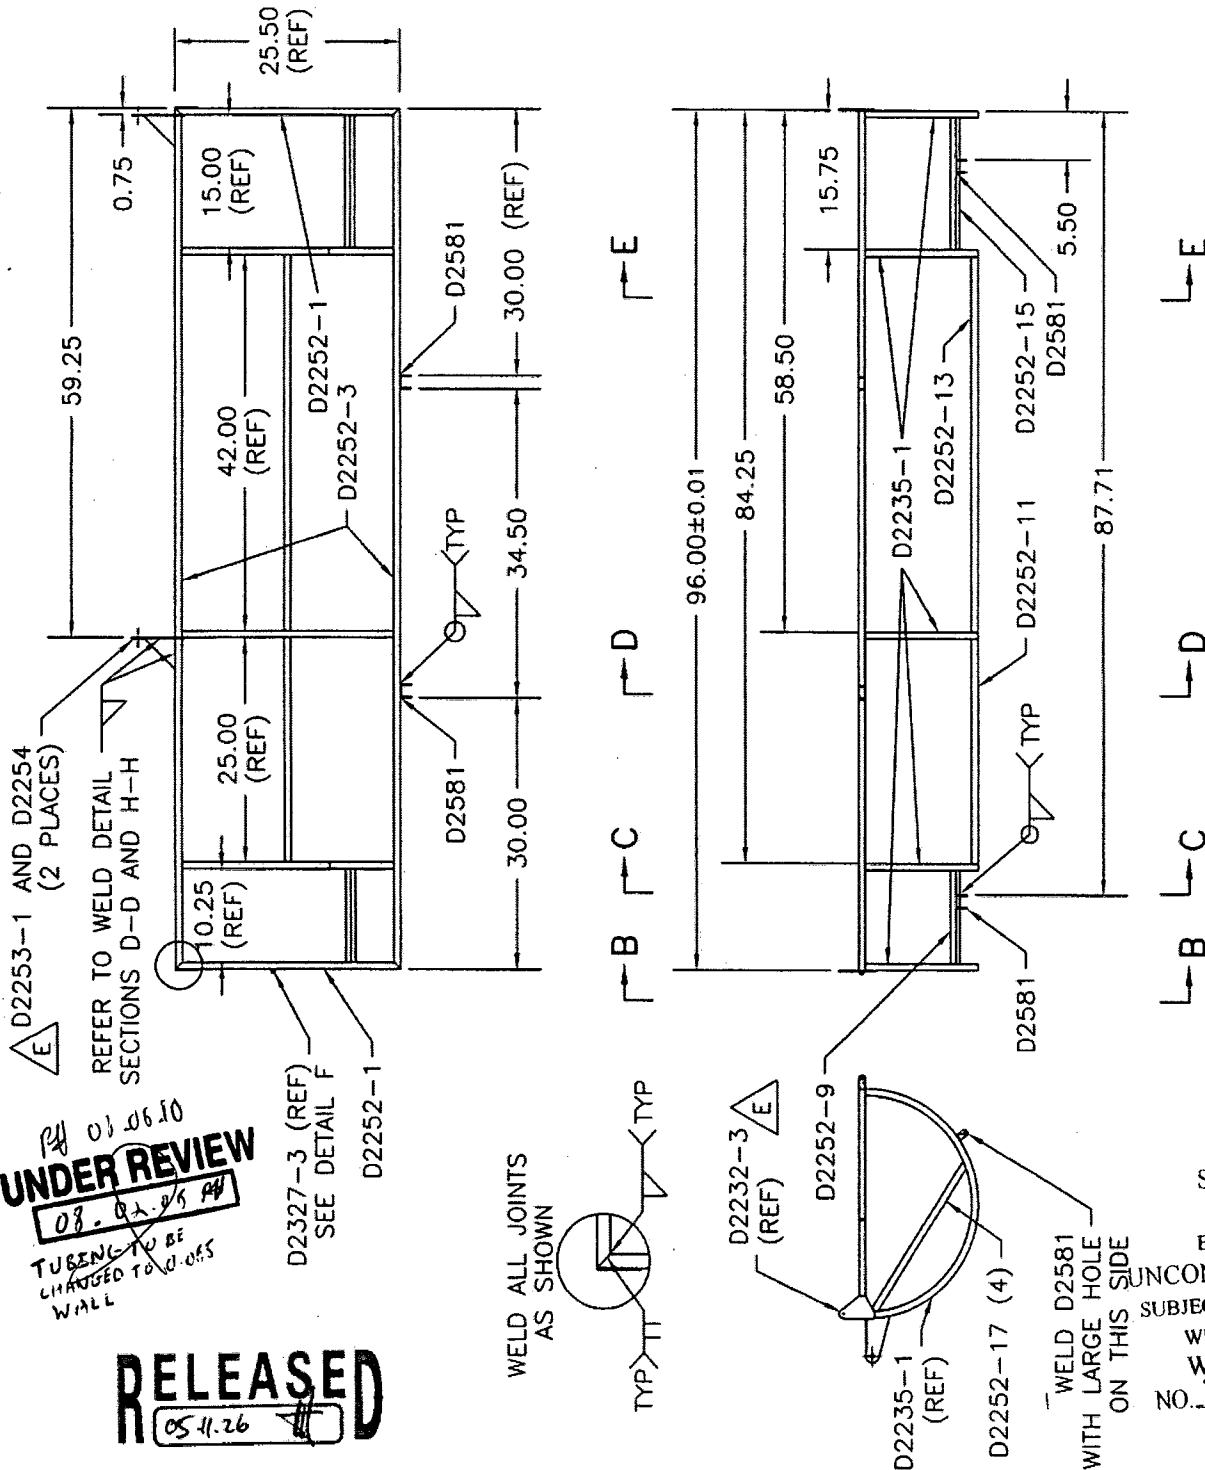

D2252-041 BASKET FRAME

08.01.06.10  
**UNDER REVIEW**  
TUBING TO BE CHANGED TO 0.065 WALL

**RELEASED**  
05.11.26


SHOP COPY  
RETURN TO  
ENGINEERING  
**UNCONTROLLED COPY**  
SUBJECT TO AMENDMENT  
WITHOUT NOTICE  
WORK ORDER  
NO. 397774

Copyright © 1994 by DART AEROSPACE LTD


THIS DOCUMENT IS PRIVATE AND CONFIDENTIAL AND IS SUPPLIED ON THE EXPRESS CONDITION THAT IT IS NOT TO BE USED FOR ANY PURPOSE OR COPIED OR COMMUNICATED TO ANY OTHER PERSON WITHOUT WRITTEN PERMISSION FROM DART AEROSPACE LTD.




|                               |                                 |   |                        |
|-------------------------------|---------------------------------|---|------------------------|
| DESIGN<br>KE                  | DRAWN BY<br>MB                  | DART AEROSPACE LTD<br>HAWKESBURY, ONTARIO, CANADA |                        |
| CHECKED<br><i>[Signature]</i> | APPROVED<br><i>[Signature]</i>  | DRAWING NO.<br>D2252                              | REV. E<br>SHEET 4 OF 5 |
| DATE<br>05.11.10              | TITLE<br>BASKET ASSEMBLY (206L) |   | SCALE<br>NTS           |

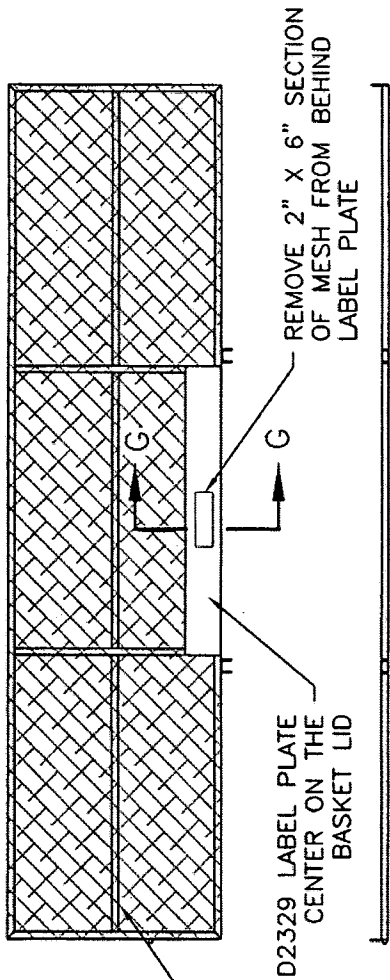

D2252-043 LID ASSEMBLY

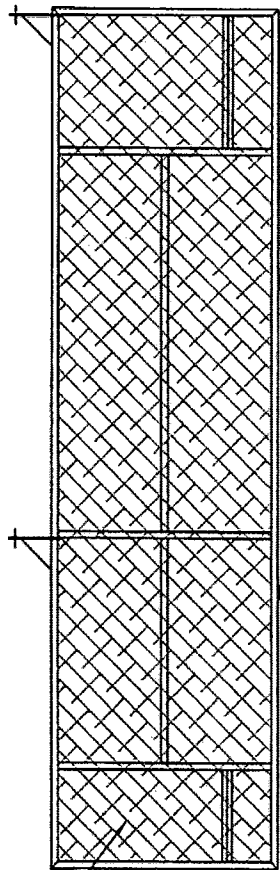


D2252-041 BASKET ASSEMBLY

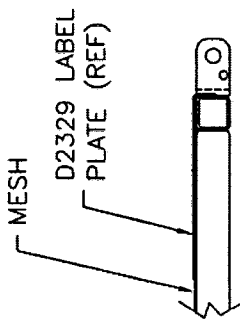

SKIN WITH 3/4-16 F EXPANDED SS, TACK WELD EACH STRAND END TO FRAME

05.06.10  
**UNDER REVIEW**  
05.06.10  
TUBING TO BE CHANGED TO 0.065 WALL

**RELEASED**  
05.11.26

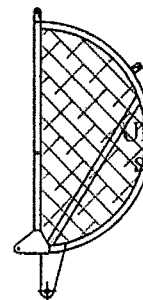






SHOP COPY  
RETURN TO  
ENGINEERING  
CONTROLLED COPY  
SUBJECT TO AMENDMENT  
WITHOUT NOTICE  
WORK ORDER  
NO. 3917917

Copyright © 1994 by DART AEROSPACE LTD

THIS DOCUMENT IS PRIVATE AND CONFIDENTIAL AND IS SUPPLIED ON THE EXPRESS CONDITION THAT IT IS NOT TO BE USED FOR ANY PURPOSE OR COPIED OR COMMUNICATED TO ANY OTHER PERSON WITHOUT WRITTEN PERMISSION FROM DART AEROSPACE LTD.



**DART**

|                               |                                |   |                        |
|-------------------------------|--------------------------------|---|------------------------|
| DESIGN<br>KE                  | DRAWN BY<br>MB                 | DART AEROSPACE LTD<br>HAWKESBURY, ONTARIO, CANADA |                        |
| CHECKED<br><i>[Signature]</i> | APPROVED<br><i>[Signature]</i> | DRAWING NO.<br>D2252                              | REV. E<br>SHEET 5 OF 5 |
| DATE<br>05.11.10              |                                | TITLE<br>BASKET ASSEMBLY (206L)                   | SCALE<br>NTS           |

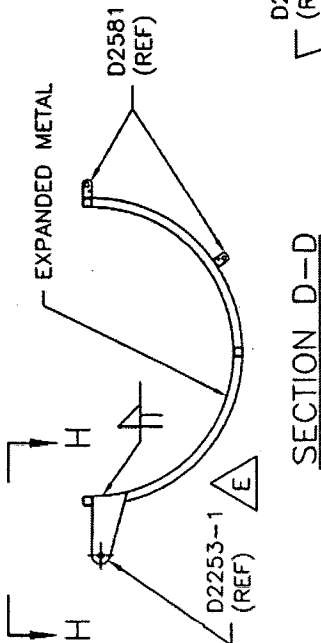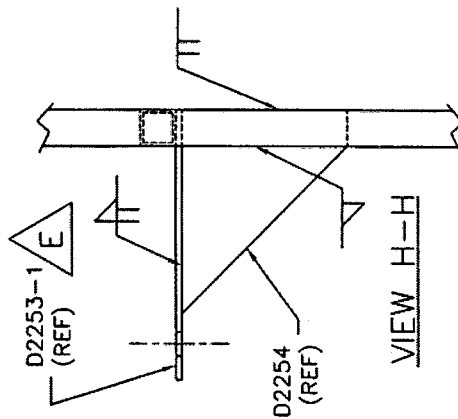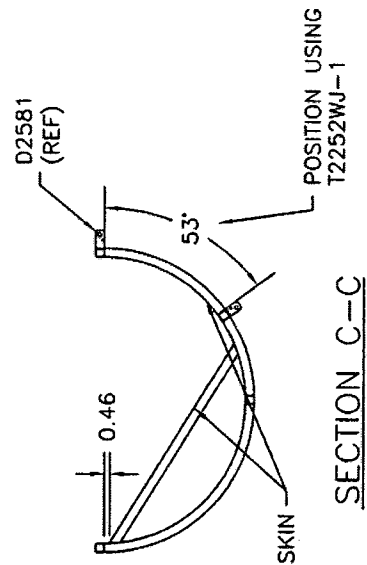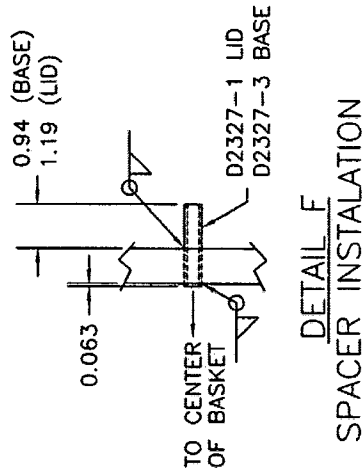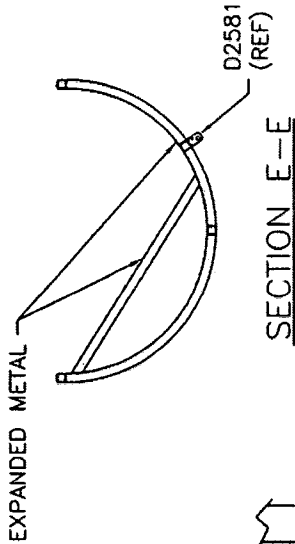

**UNDER REVIEW**  
08.04.05 PM  
TUBING TO BE  
CHANGED TO 0.065  
WALL

**RELEASED**  
05.11.26

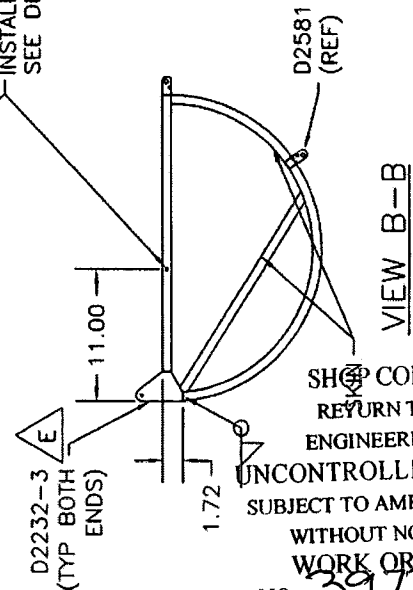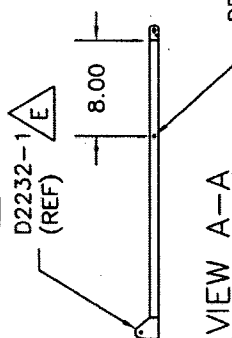

SHO COPY  
RETURN TO  
ENGINEERING  
UNCONTROLLED COPY  
SUBJECT TO AMENDMENT  
WITHOUT NOTICE  
WORK ORDER  
NO. 391794

Copyright © 1994 by DART AEROSPACE LTD

THIS DOCUMENT IS PRIVATE AND CONFIDENTIAL AND IS SUPPLIED ON THE EXPRESS CONDITION THAT IT IS NOT TO BE USED FOR ANY PURPOSE OR COPIED OR COMMUNICATED TO ANY OTHER PERSON WITHOUT WRITTEN PERMISSION FROM DART AEROSPACE LTD.

Date: Tuesday, 10/06/2008 12:54:11 PM  
 User: Julie Lecocq

## Process Sheet

|                                    |   |                           |                 |
|------------------------------------|---|---------------------------|-----------------|
| <b>Customer</b> :                  | CU-DAR001 Dart Helicopters Services         | <b>Drawing Name</b> :     | 206L BASKET LID |
| <b>Job Number</b> :                | 39779B                                      |                           |                 |
| <b>Estimate Number</b> :           | 11274                                       |                           |                 |
| <b>P.O. Number</b> :               |   | <b>Part Number</b> :      | D2252043        |
| <b>This Issue</b> :                | 10/06/2008                                  | <b>S.O. No.</b> :         |                 |
| <b>Prsht Rev.</b> :                | NC  | <b>Drawing Number</b> :   | D2252 REV E     |
| <b>First Issue</b> :               | / /   | <b>Project Number</b> :   | N/A             |
| <b>Previous Run</b> :              | 36655B                                      | <b>Drawing Revision</b> : | E               |
| <b>Written By</b> :                |   | <b>Material</b> :         |                 |
| <b>Checked &amp; Approved By</b> : | JUD 08.6.10                                 | <b>Due Date</b> :         | 30/06/2008      |
| <b>Comment</b> :                   | Est Rev:1 REVISED AS PER REV E 05-12-06 JLM |                           |                 |

Qty: 1 Um: Each

## Additional Product

Job Number:



|                |                              |                      |
|----------------|------------------------------|----------------------|
| <b>Seq. #:</b> | <b>Machine Or Operation:</b> | <b>Description :</b> |
|----------------|------------------------------|----------------------|

|     |                |                          |
|-----|----------------|--------------------------|
| 1.0 | M304TS0750W065 | 304 SQ Tube.75x.75x.065W |
|-----|----------------|--------------------------|



0.065 W 01.06.10



Comment: Qty.: 32.5539 f(s)/Unit Total : 32.5539 f(s)

3/4" x 3/4" x 0.063 wall 304/316 SS tubing.

Batch: M108250

SAD 08/07/10

①

|     |             |                              |
|-----|-------------|------------------------------|
| 2.0 | LARGE FAB 1 | LARGE FABRICATION RESOURCE 1 |
|-----|-------------|------------------------------|



Comment: LARGE FABRICATION RESOURCE 1

1- Cut D2252-1-3-9 as per Dwg D2252

SAD

08/07/10

①

2-Drill hole in D2252-1 as per Dwg D2252

3-Deburr & Remove all Markings from Material

|     |       |             |
|-----|-------|-------------|
| 3.0 | D2329 | Label Plate |
|-----|-------|-------------|



Comment: Qty.: 1.0000 Each(s)/Unit Total : 1.0000 Each(s)

Pick:

Qty Part Number Description

Batch

1 D2329

Label Plate

B35686

SAD 08/07/22

|     |        |                |
|-----|--------|----------------|
| 4.0 | D23271 | Spacer Bushing |
|-----|--------|----------------|



Comment: Qty.: 1.0000 Each(s)/Unit Total : 1.0000 Each(s)

Pick:

Qty Part Number Description

Batch

1 D2327-1

Bushing

B40084

SAD 08/07/21

**Dart Aerospace Ltd**

| W/O: |      | WORK ORDER CHANGES |    |      |     |                                     |                          |
|------|------|--------------------|----|------|-----|-------------------------------------|--------------------------|
| DATE | STEP | PROCEDURE CHANGE   | By | Date | Qty | Approval<br>Chief Eng /<br>Prod Mgr | Approval<br>QC Inspector |
|      |      |                    |    |      |     |                                     |                          |
|      |      |                    |    |      |     |                                     |                          |

Part No: \_\_\_\_\_ PAR #: \_\_\_\_\_ Fault Category: \_\_\_\_\_ NCR: Yes No DQA: \_\_\_\_\_ Date: \_\_\_\_\_

QA: N/C Closed: \_\_\_\_\_ Date: \_\_\_\_\_

| NCR: |      | WORK ORDER NON-CONFORMANCE (NCR) |                             |                                 |                |                           |                       |                          |
|------|------|----------------------------------|-----------------------------|---------------------------------|----------------|---------------------------|-----------------------|--------------------------|
| DATE | STEP | Description of NC<br>Section A   | Corrective Action Section B |                                 |                | Verification<br>Section C | Approval<br>Chief Eng | Approval<br>QC Inspector |
|      |      |                                  | Initial<br>Chief Eng        | Action Description<br>Chief Eng | Sign &<br>Date |                           |                       |                          |
|      |      |                                  |                             |                                 |                |                           |                       |                          |
**NOTE:** Date & initial all entries

Date: Tuesday, 10/06/2008 12:54:11 PM  
User: Julie Lecocq

## Process Sheet

Customer: CU-DAR001 Dart Helicopters Services

Drawing Name: 206L BASKET LID

Job Number: 39779B

Part Number: D2252043

Job Number:



Seq. #:

Machine Or Operation:

Description :

5.0

D22321

Basket Hinge



Comment: Qty.: 2.0000 Each(s)/Unit Total : 2.0000 Each(s)

Pick:

Qty Part Number

Description

Batch

2 D2232-1

HINGE

B39454

JS 08/07/21

6.0

D2581

Mounting Bracket



Comment: Qty.: 2.0000 Each(s)/Unit Total : 2.0000 Each(s)

Pick:

Qty Part Number

Description

Batch

2 D2581

Mounting Chancel

B39046

JS 08/07/21

7.0

M304EX07516F

Expanded Metal Flat Stai



Comment: Qty.: 18.9000 sf(s)/Unit Total : 18.9000 sf(s)

Pick:

Qty Part Number

Description

Batch

18 sf M304EX0.75-16F Expanded Metal

108474

SAP 08/07/14 D

8.0

LARGE FAB 1

LARGE FABRICATION RESOURCE 1



Comment: LARGE FABRICATION RESOURCE 1

1-Weld as per Dwg D2252 using Welding Table and corner Jig

Deburr as required

A/R SS ROD

Batch: M107051

JS 08/07/22

9.0

QC9

VISUAL WELDING INSPECTION



Comment: VISUAL WELDING INSPECTION

PD 08-07-23

10.0

QC5

INSPECT WORK TO CURRENT STEP








Comment: INSPECT WORK TO CURRENT STEP

SOB 08/07/23

# Dart Aerospace Ltd

| W/O: |      | WORK ORDER CHANGES |    |      |     |                                     |                          |
|------|------|--------------------|----|------|-----|-------------------------------------|--------------------------|
| DATE | STEP | PROCEDURE CHANGE   | By | Date | Qty | Approval<br>Chief Eng /<br>Prod Mgr | Approval<br>QC Inspector |
|      |      |                    |    |      |     |                                     |                          |
|      |      |                    |    |      |     |                                     |                          |

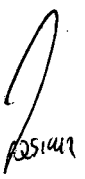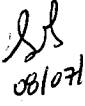Part No: D2252-043 PAR #: N/A Fault Category: Prod / Ins. Large NCR: Yes No DQA: D Date: 08/07/22  
 QA: N/C Closed: D Date: 08/07/22

| NCR: <u>39779 B</u> |      | WORK ORDER NON-CONFORMANCE (NCR)  |  |   |   |  |  |  |
|---------------------|------|---|--|---|---|--|--|--|
| DATE                | STEP | Description of NC<br>Section A  | Corrective Action Section B  |   |   | Verification<br>Section C  | Approval<br>Chief Eng  | Approval<br>QC Inspector   |
|                     |      |   | Initial<br>Chief Eng   | Action Description<br>Chief Eng   | Sign &<br>Date  |  |  |  |
| 08/07/22            | B.O  | After welding lid from welder notices that he has two D23271 Bushings (Basket only needs 1).<br>R.C. under <del>two</del> <u>one</u> D2252-1 each with the hole for the D23271 Bushings. He didn't pay attention and welded the bushings in place. What did not pay attention to DWG. |  | <ul style="list-style-type: none"> <li>Remove bushing.</li> <li>drill a tiny hole @ the end of the lid to remove any foreign objects.</li> <li>Fill holes with weld per QSI 004 Rod m <u>M1007051</u> A/R.</li> <li>grind flush.</li> <li>Ensure to verify the Dwg: Assembly to the parts being used..</li> </ul> | <br>08/07/22 | <br>08/07/22 | <br>08/07/22 | <br>08/07/22 |
|                     |      |   |  |   |   |  |  |  |
|                     |      |   |  |   |   |  |  |  |

NOTE: Date & initial all entries



Date: Tuesday, 10/06/2008 12:54:12 PM  
User: Julie Lecocq

## Process Sheet

Customer: CU-DAR001 Dart Helicopters Services

Drawing Name: 206L BASKET LID

Job Number: 39779B

Part Number: D2252043

Job Number:



Seq. #:

Machine Or Operation:

Description :

11.0

POWDER COATING

POWDER COATING



N/108523



Comment: POWDER COATING

Powder Coat White Gloss (Ref: 4.3.5.1) as per QSI 005 4.3

START TIME:

OVEN TEMPERATURE:

FINISH TIME:

1:10  
4:00  
1:40

M-L 08/07/23

12.0

QC3

INSPECT POWDER COAT/CHEMICAL CONVERSION



Comment: INSPECT POWDER COAT/CHEMICAL CONVERSION

SL 08-07-23

13.0

PACKAGING 1

PACKAGING RESOURCE #1



Comment: PACKAGING RESOURCE #1

Identify and Stock

Location: 6-A

EP 08/07/24

14.0

QC21

FINAL INSPECTION/W/O RELEASE



08/07/30

Comment: FINAL INSPECTION/W/O RELEASE

Job Completion



mf 08-07-30

**Dart Aerospace Ltd**

| W/O: |      | WORK ORDER CHANGES |    |      |     |                                     |                          |
|------|------|--------------------|----|------|-----|-------------------------------------|--------------------------|
| DATE | STEP | PROCEDURE CHANGE   | By | Date | Qty | Approval<br>Chief Eng /<br>Prod Mgr | Approval<br>QC Inspector |
|      |      |                    |    |      |     |                                     |                          |
|      |      |                    |    |      |     |                                     |                          |

Part No: \_\_\_\_\_ PAR #: \_\_\_\_\_ Fault Category: \_\_\_\_\_ NCR: Yes No DQA: \_\_\_\_\_ Date: \_\_\_\_\_

QA: N/C Closed: \_\_\_\_\_ Date: \_\_\_\_\_

| NCR: |      | WORK ORDER NON-CONFORMANCE (NCR) |                             |                                 |                |                           |                       |                          |
|------|------|----------------------------------|-----------------------------|---------------------------------|----------------|---------------------------|-----------------------|--------------------------|
| DATE | STEP | Description of NC<br>Section A   | Corrective Action Section B |                                 |                | Verification<br>Section C | Approval<br>Chief Eng | Approval<br>QC Inspector |
|      |      |                                  | Initial<br>Chief Eng        | Action Description<br>Chief Eng | Sign &<br>Date |                           |                       |                          |
|      |      |                                  |                             |                                 |                |                           |                       |                          |
**NOTE:** Date & initial all entries


**DART****RELEASED**  
05.11.26

|                     |                       |  |                        |
|---------------------|-----------------------|--|------------------------|
| DESIGN<br><b>KE</b> | DRAWN BY<br><b>MB</b> | <b>DART AEROSPACE LTD</b><br>HAWKESBURY, ONTARIO, CANADA                                   |                        |
| CHECKED<br><b>#</b> | APPROVED<br><b>#</b>  | DRAWING NO.<br>D2252   | REV. E<br>SHEET 1 OF 5 |
| DATE<br>05.11.10    |                       | TITLE<br>BASKET ASSEMBLY (206L)  | SCALE<br>NTS           |
| C                   | 95.12.11              | RE-DRAWN   |                        |
| D                   | 99.09.14              | MODIFIED LATCH, D2581 WAS D2255-3  |                        |
| E                   | 05.11.10              | D2253-1 WAS D2253 (NCR 533),<br>ADDED MEMBERS TO LID FRAME,<br>ADDED D2232-1/-3 & D2252-19 |                        |

| Qty<br>-041 | Qty<br>-043 | Part Number | Description            | L     | A  |
|-------------|-------------|-------------|------------------------|-------|----|
| X           |             | D2252-041   | BASKET ASSEMBLY        |       |    |
|             | X           | D2252-043   | LID ASSEMBLY           |       |    |
|             | 2           | D2232-1     | HINGE                  |       |    |
| 2           |             | D2232-3     | HINGE                  |       |    |
| 5           |             | D2235-1     | RIB                    |       |    |
| 2           | 2           | D2252-1     | FRAME                  | 25.50 | 45 |
| 2           |             | D2252-3     | FRAME                  | 96.00 | 45 |
|             | 2           | D2252-7     | FRAME                  | 24.00 | 90 |
| 1           |             | D2252-9     | FRAME                  | 10.25 | 90 |
| 1           |             | D2252-11    | FRAME                  | 25.00 | 90 |
| 1           |             | D2252-13    | FRAME                  | 42.00 | 90 |
| 1           |             | D2252-15    | FRAME                  | 15.00 | 90 |
| 4           |             | D2252-17    | FRAME                  | 19.78 | 53 |
|             | 2           | D2252-19    | FRAME                  | 95.27 | 45 |
|             | 2           | D2252-21    | FRAME                  | 30.82 | 90 |
|             | 1           | D2252-23    | FRAME                  | 30.62 | 90 |
| 2           |             | D2253-1     | LUG                    |       |    |
| 2           |             | D2254       | GUSSET                 |       |    |
|             | 1           | D2327-1     | BUSHING                |       |    |
| 1           |             | D2327-3     | BUSHING                |       |    |
|             | 1           | D2329       | LABEL PLATE            |       |    |
| 4           | 2           | D2581       | MOUNTING CHANNEL       |       |    |
| A/R         | A/R         |             | 3/4-16F EXPANDED METAL |       |    |

**NOTES:**

- MATERIAL: AISI 304/316 SS 3/4 X 3/4 X 0.060 WALL SQUARE TUBE  
(REF. DART SPEC. M304TS0.750W.060)
- FINISH: POWDER COAT ASSEMBLY GLOSS WHITE (4.3.5.2) PER DART QSI 005 4.3
- WELD PER DART QSI 004
- ALL DIMENSION ARE IN INCHES
- TOLERANCES ARE PER DART QSI 018 UNLESS OTHERWISE NOTED.

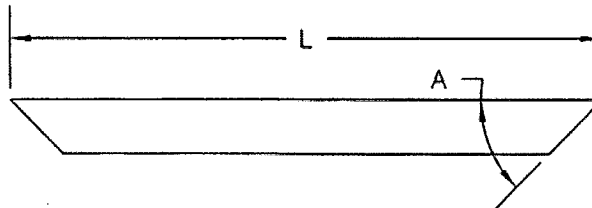**CUT SIZE DETAIL**

0.065 **PH** 01.06.10  
**UNDER REVIEW**  
08/02/05 **PH**  
TUBING TO BE  
CHANGED TO 0.065  
WALL RETURN TO  
ENGINEERING  
UNCONTROLLED COPY  
SUBJECT TO AMENDMENT  
WITHOUT NOTICE  
WORK ORDER  
NO. 3779B

**Copyright © 1994 by DART AEROSPACE LTD**

THIS DOCUMENT IS PRIVATE AND CONFIDENTIAL AND IS SUPPLIED ON THE EXPRESS CONDITION THAT IT IS NOT TO BE USED FOR ANY PURPOSE OR COPIED OR COMMUNICATED TO ANY OTHER PERSON WITHOUT WRITTEN PERMISSION FROM DART AEROSPACE LTD.


**DART**

|                               |                                |   |                        |
|-------------------------------|--------------------------------|---|------------------------|
| DESIGN<br>KE                  | DRAWN BY<br>MB                 | DART AEROSPACE LTD<br>HAWKESBURY, ONTARIO, CANADA |                        |
| CHECKED<br><i>[Signature]</i> | APPROVED<br><i>[Signature]</i> | DRAWING NO.<br>D2252                              | REV. E<br>SHEET 2 OF 5 |
| DATE<br>05.11.10              |                                | TITLE<br>BASKET ASSEMBLY (206L)                   | SCALE<br>NTS           |

**RELEASED**  
05.11.26 *[Signature]*

**UNDER REVIEW**  
08.01.06 *[Signature]*

TUBING TO BE  
CHANGED TO 0.065  
WALL  
*[Signature]*  
06.06.10

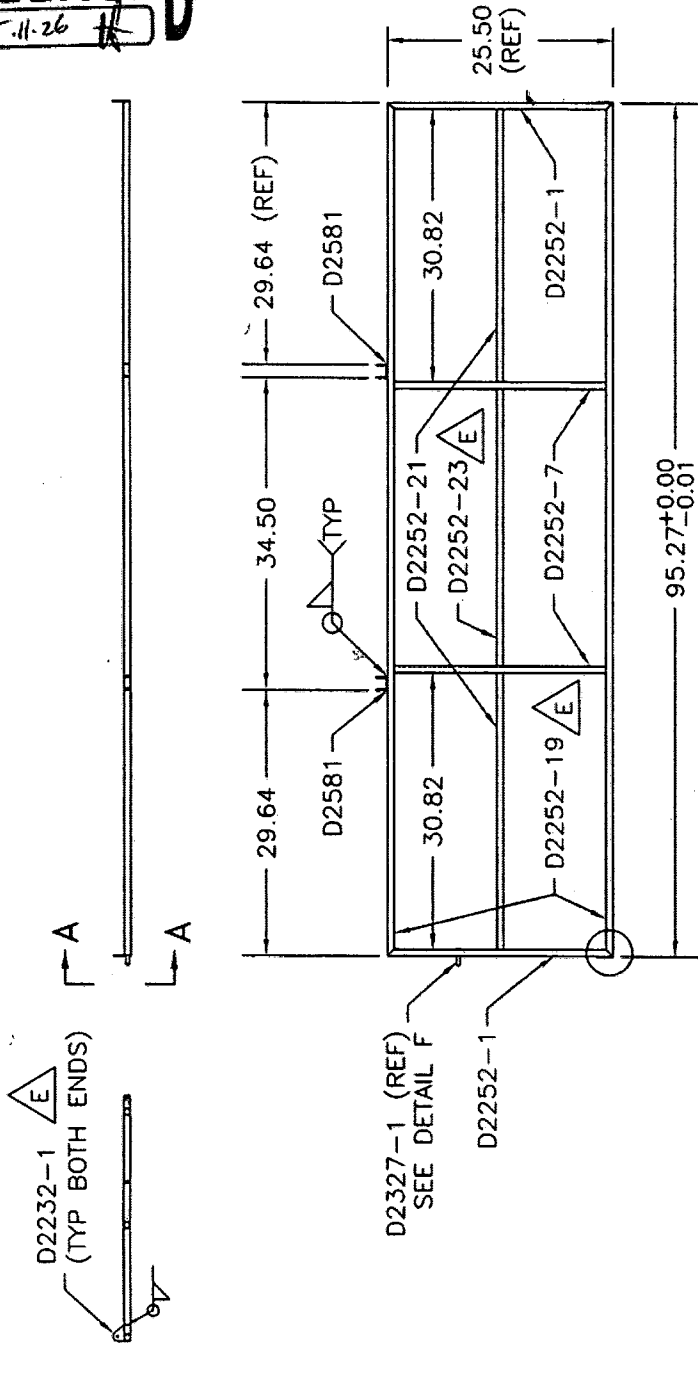

D2252-043 LID FRAME


SHOP COPY  
RETURN TO  
ENGINEERING  
UNCONTROLLED COPY  
SUBJECT TO AMENDMENT  
WITHOUT NOTICE  
WORK ORDER  
NO. 3917 *[Signature]*

Copyright © 1994 by DART AEROSPACE LTD



THIS DOCUMENT IS PRIVATE AND CONFIDENTIAL AND IS SUPPLIED ON THE EXPRESS CONDITION THAT IT IS NOT TO BE USED FOR ANY PURPOSE OR COPIED OR COMMUNICATED TO ANY OTHER PERSON WITHOUT WRITTEN PERMISSION FROM DART AEROSPACE LTD.

**DART**


|         |                    |          |                    |                             |
|---------|--------------------|----------|--------------------|-----------------------------|
| DESIGN  | KE                 | DRAWN BY | MB                 | DART AEROSPACE LTD          |
| CHECKED | <i>[Signature]</i> | APPROVED | <i>[Signature]</i> | HAWKESBURY, ONTARIO, CANADA |
| DATE    | 05.11.10           | TITLE    | D2252              | REV. E                      |
|         |                    |          |                    | SHEET 3 OF 5                |
|         |                    |          |                    | SCALE                       |
|         |                    |          |                    | NIS                         |

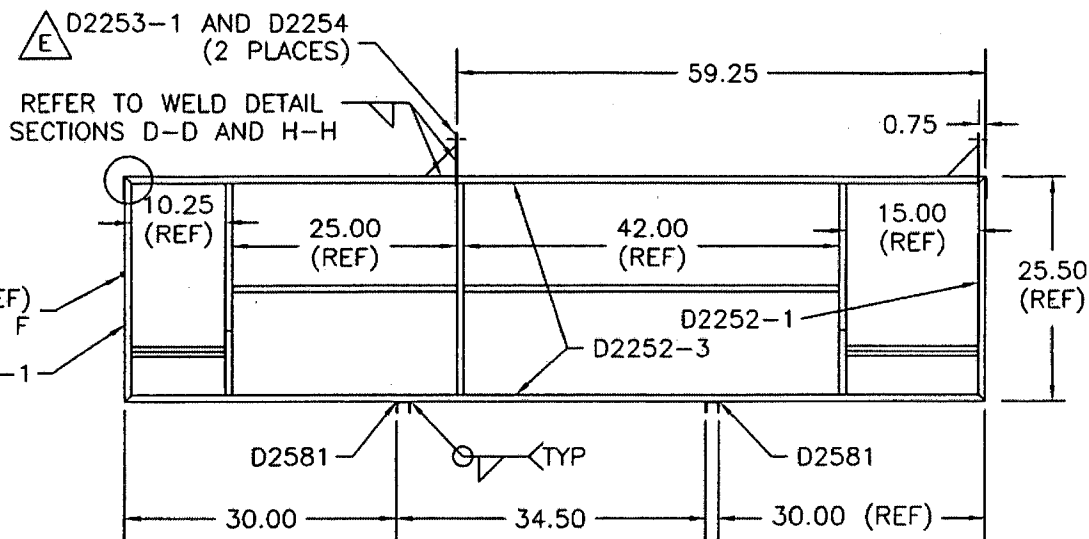

WELD ALL JOINTS  
AS SHOWN

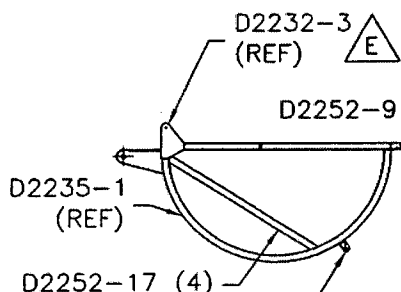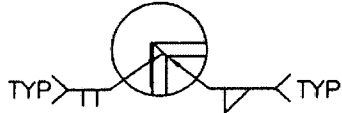

WELD D2581  
WITH LARGE HOLE  
ON THIS SIDE

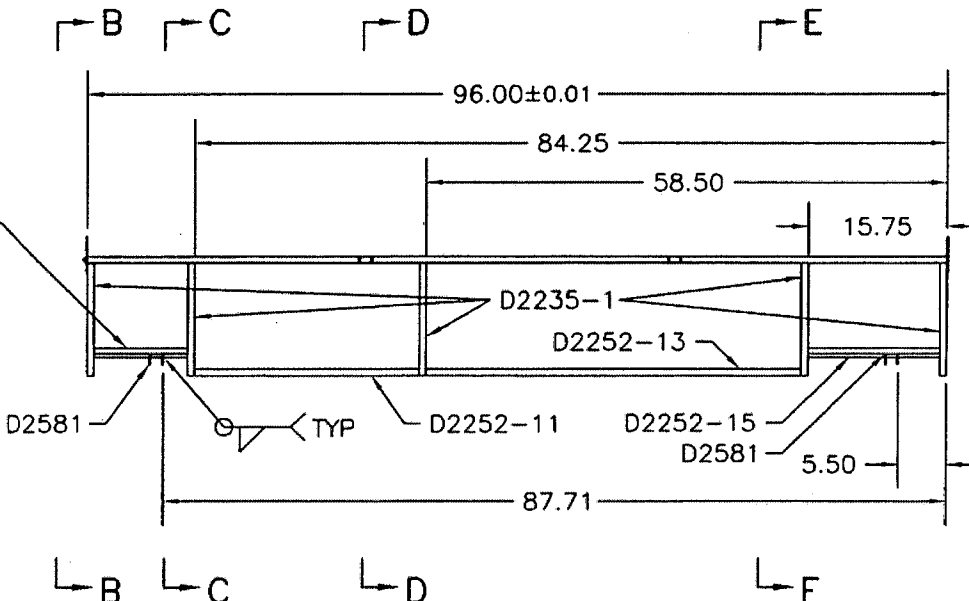

D2252-041 BASKET FRAME

**UNDER REVIEW**  
08.02.05  
TUBING TO BE  
CHANGED TO 0.065  
WALL

**RELEASED**  
05.11.26


THIS DOCUMENT IS PRIVATE AND CONFIDENTIAL AND IS SUPPLIED ON THE EXPRESS CONDITION THAT IT IS NOT TO BE USED FOR ANY PURPOSE OR COPIED OR COMMUNICATED TO ANY OTHER PERSON WITHOUT WRITTEN PERMISSION FROM DART AEROSPACE LTD.

Copyright © 1994 by DART AEROSPACE LTD


SHOP COPY  
RETURN TO  
ENGINEERING  
UNCONTROLLED COPY  
SUBJECT TO AMENDMENT  
WITHOUT NOTICE  
WORK ORDER  
NO. 397798




|         |                    |          |                    |   |                        |
|---------|--------------------|----------|--------------------|---|------------------------|
| DESIGN  | KE                 | DRAWN BY | MB                 | DART AEROSPACE LTD<br>HAWKESBURY, ONTARIO, CANADA |                        |
| CHECKED | <i>[Signature]</i> | APPROVED | <i>[Signature]</i> | DRAWING NO.<br>D2252                              | REV. E<br>SHEET 4 OF 5 |
| DATE    | 05.11.10           |          |                    | TITLE<br>BASKET ASSEMBLY (206L)                   | SCALE<br>NTS           |

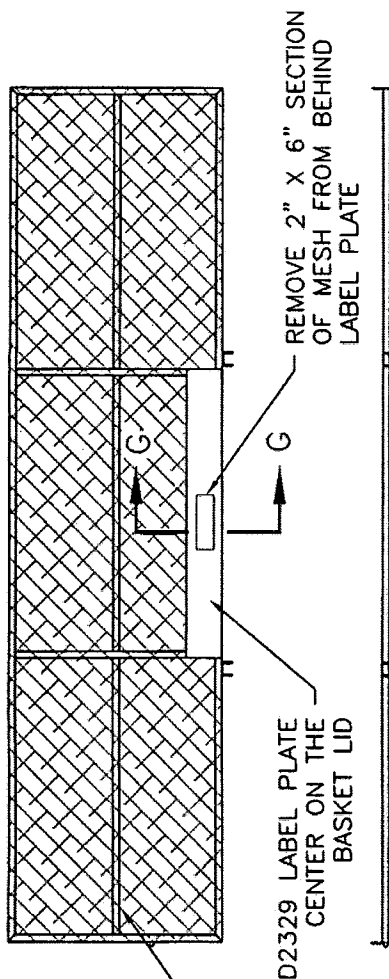

D2252-043 LID ASSEMBLY

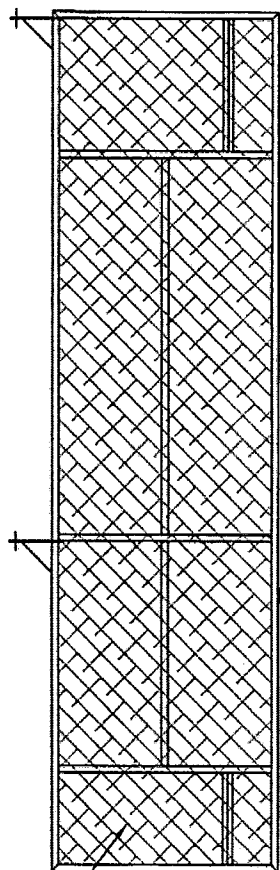

D2252-041 BASKET ASSEMBLY

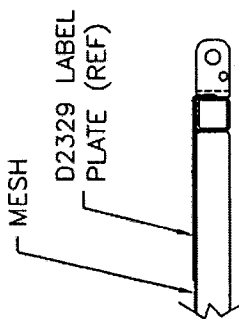


SECTION G-G



SKIN WITH 3/4-16 F  
EXPANDED SS, TACK  
WELD EACH STRAND  
END TO FRAME

*[Signature]* 06.06.10  
**UNDER REVIEW**  
08.01.05 *[Signature]*  
TUBING TO BE  
CHANGED TO 0-085  
WALL

**RELEASED**  
05.11.26 *[Signature]*

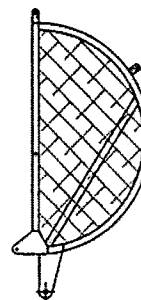






SHOP COPY  
RETURN TO  
ENGINEERING  
UNCONTROLLED COPY  
SUBJECT TO AMENDMENT  
WITHOUT NOTICE  
WORK ORDER  
NO. *39779B*

Copyright © 1994 by DART AEROSPACE LTD

THIS DOCUMENT IS PRIVATE AND CONFIDENTIAL AND IS SUPPLIED ON THE EXPRESS CONDITION THAT IT IS NOT TO BE USED FOR ANY PURPOSE OR COPIED OR COMMUNICATED TO ANY OTHER PERSON WITHOUT WRITTEN PERMISSION FROM DART AEROSPACE LTD.



**DART**

|                               |                                 |   |                        |
|-------------------------------|---------------------------------|---|------------------------|
| DESIGN<br>KE                  | DRAWN BY<br>MB                  | DART AEROSPACE LTD<br>HAWKESBURY, ONTARIO, CANADA |                        |
| CHECKED<br><i>[Signature]</i> | APPROVED<br><i>[Signature]</i>  | DRAWING NO.<br>D2252                              | REV. E<br>SHEET 5 OF 5 |
| DATE<br>05.11.10              | TITLE<br>BASKET ASSEMBLY (206L) |   | SCALE<br>NTS           |

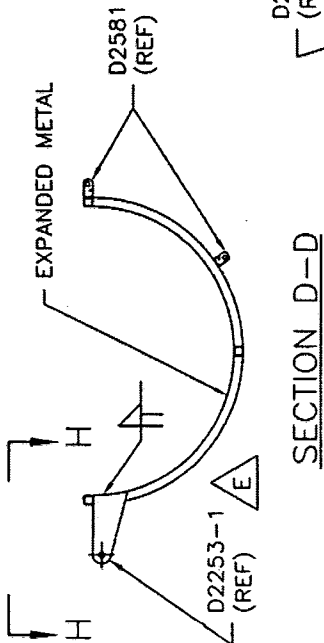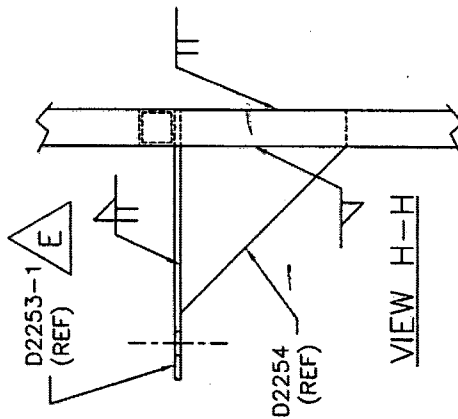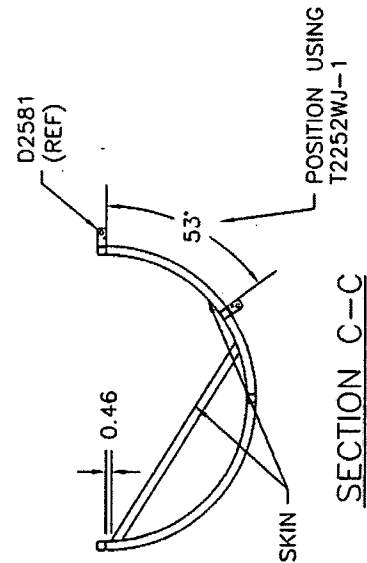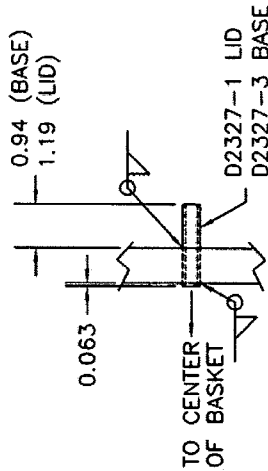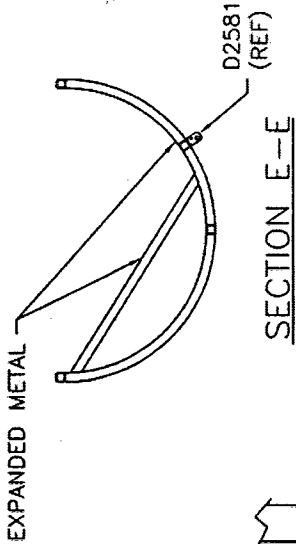

06.06.10  
**UNDER REVIEW**  
08.02.05  
TUBING TO BE  
CHANGED TO 0.065  
WALL

**RELEASED**  
05.11.26

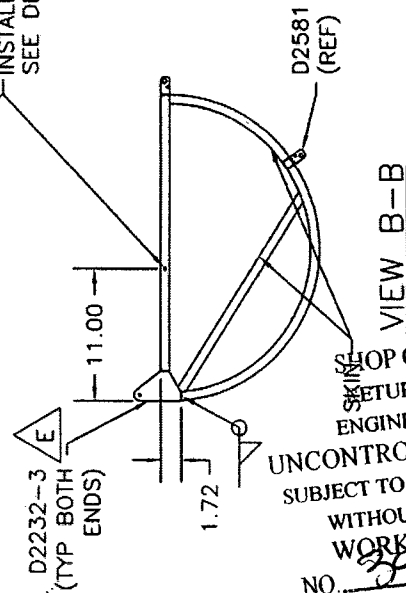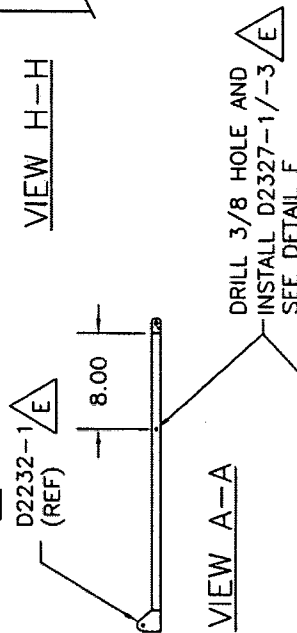

TOP COPY  
RETURN TO  
ENGINEERING  
UNCONTROLLED COPY  
SUBJECT TO AMENDMENT  
WITHOUT NOTICE  
WORK ORDER  
NO. 39779B

Copyright © 1994 by DART AEROSPACE LTD

THIS DOCUMENT IS PRIVATE AND CONFIDENTIAL AND IS SUPPLIED ON THE EXPRESS CONDITION THAT IT IS NOT TO BE USED FOR ANY PURPOSE OR COPIED OR COMMUNICATED TO ANY OTHER PERSON WITHOUT WRITTEN PERMISSION FROM DART AEROSPACE LTD.